




5

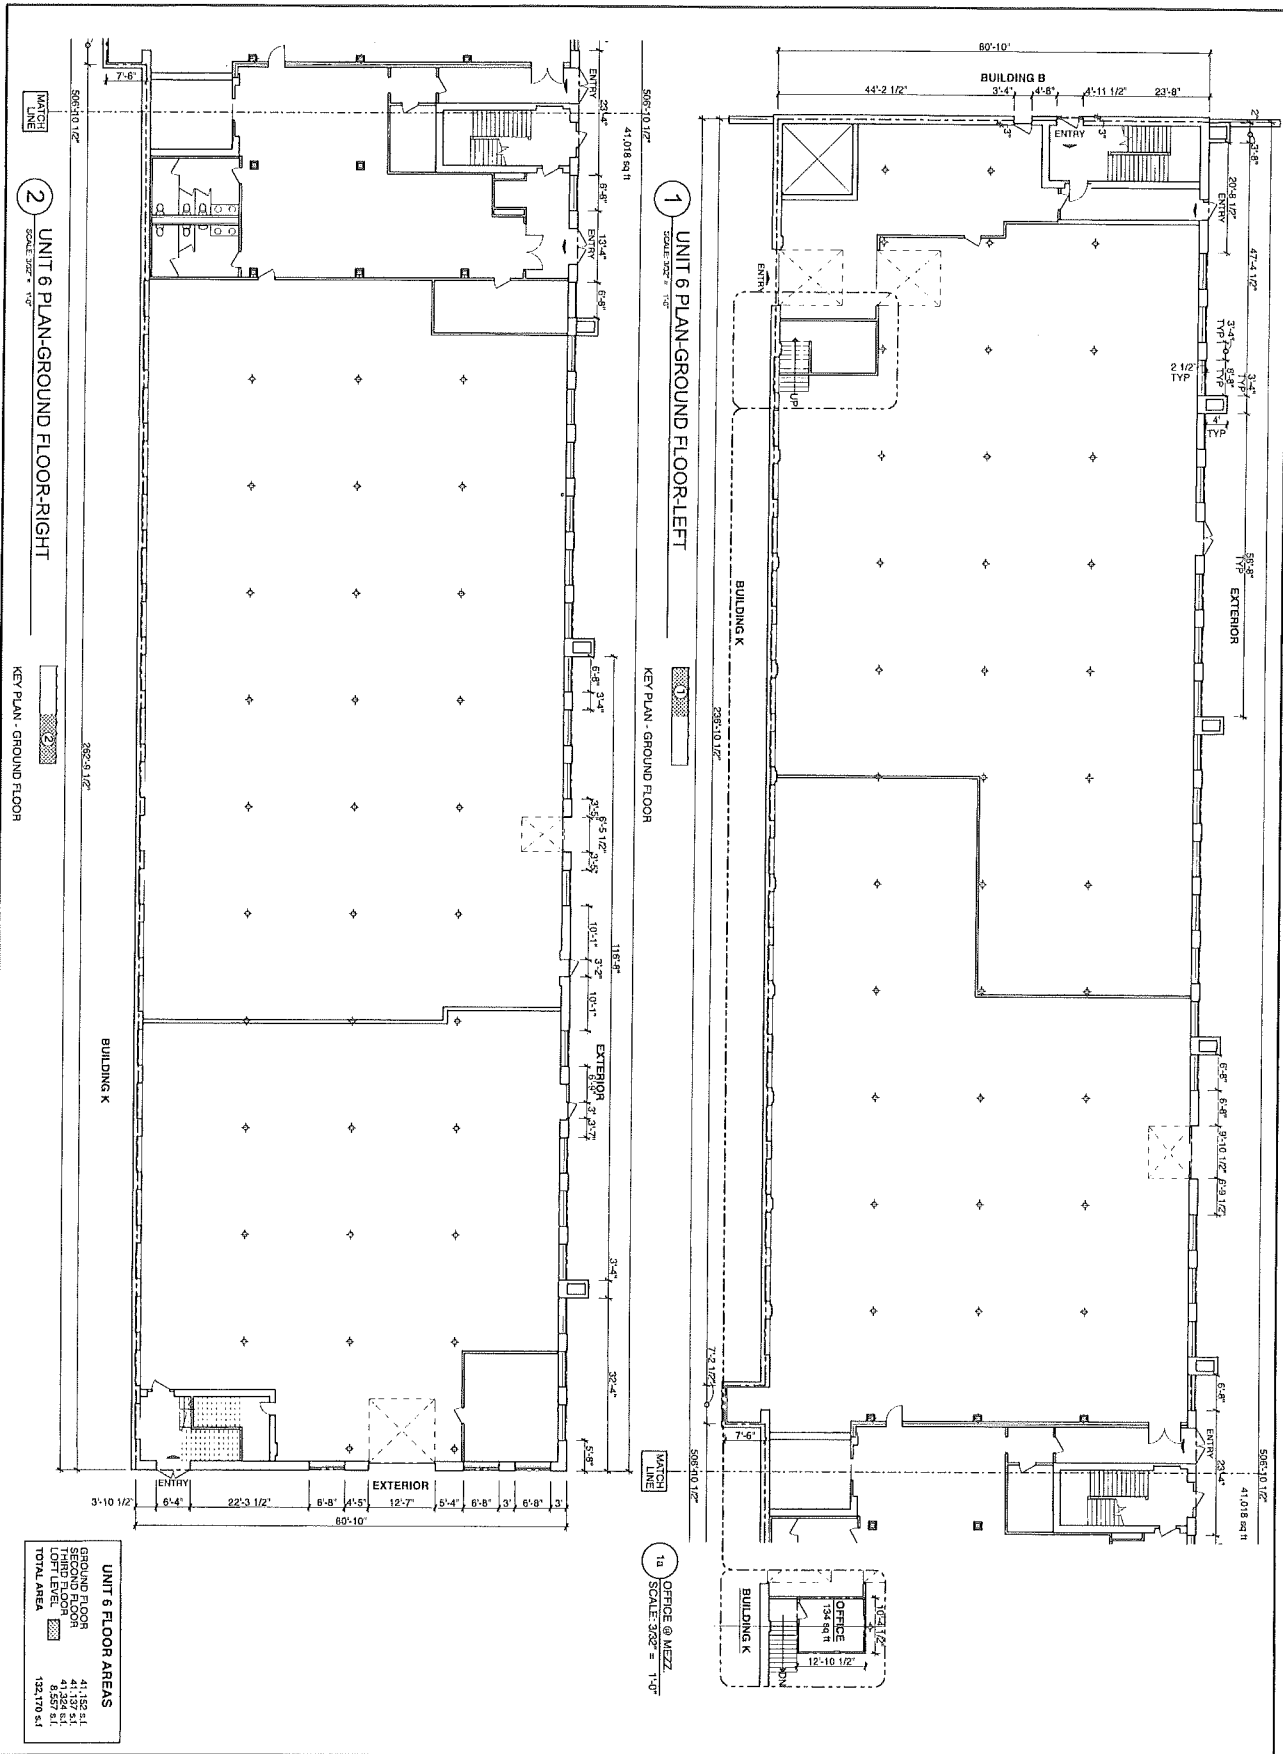

2 UNIT 6 PLAN-GROUND FLOOR-RIGHT

KEY PLAN - GROUND FLOOR

UNIT 6 FLOOR AREAS

GROUND FLOOR	41,182 S.F.
LOFT LEVEL	41,187 S.F.
TOTAL AREA	82,369 S.F.


1 UNIT 6 PLAN-GROUND FLOOR-LEFT

KEY PLAN - GROUND FLOOR

1a OFFICE @ MEZZ. SCALE 3/32" = 1'-0"

2010-5  
2010-5  
2010-5

RESERVED FOR REGISTRY USE

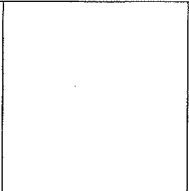

I hereby certify that these plans have been prepared in accordance with the rules and regulations of the Registry of Deeds.

Registered Architect  
Date 12/27/01  
146 Reg. # 5172

Project No:  
21 Bedford Ave Drive  
Westinghouse Plaza  
Boston, MA 02116  
(617) 578-0842 Fax (617) 578-5543


Date: 12/27/01  
Scale: 3/32" = 1'-0"

North arrow symbol.

MASTER DEED FILING  
FLOOR PLANS


UNIT 6  
MOTHER BROOK CONDOMINIUM  
WESTINGHOUSE PLAZA  
DAMON PLACE BOSTON, MA 02136

3

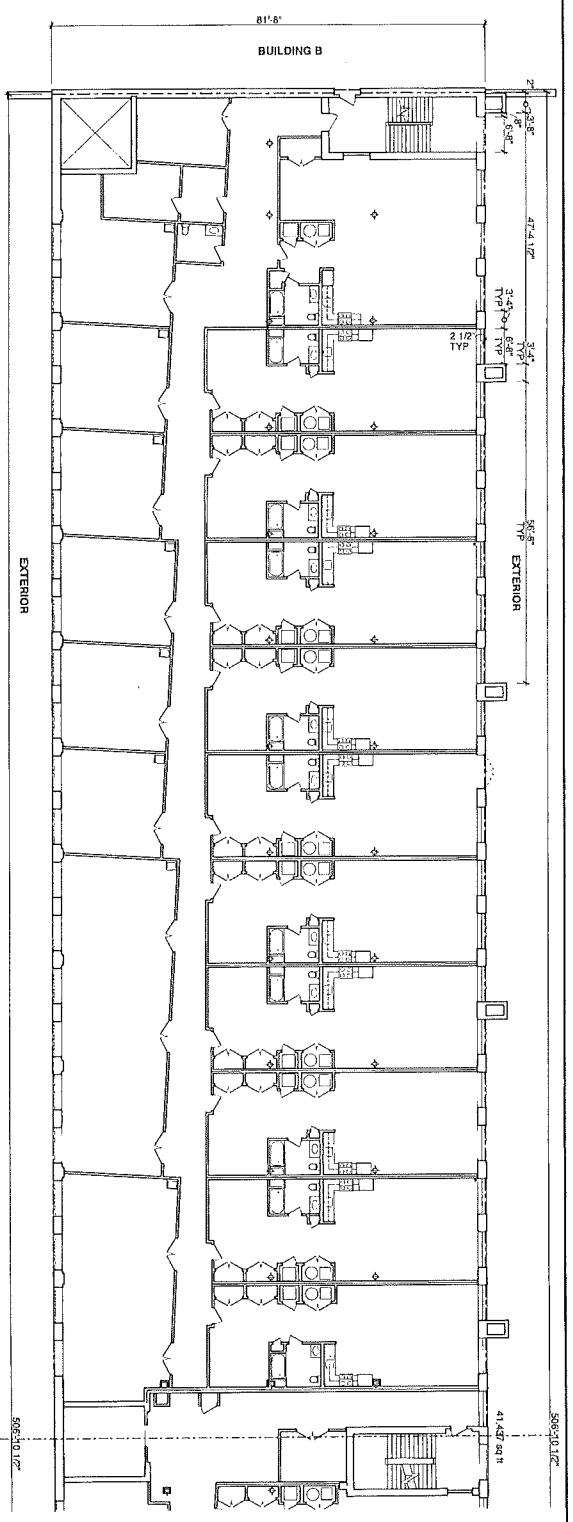

1 UNIT 6 PLAN-SECOND FLOOR-LEFT

KEY PLAN - SECOND FLOOR

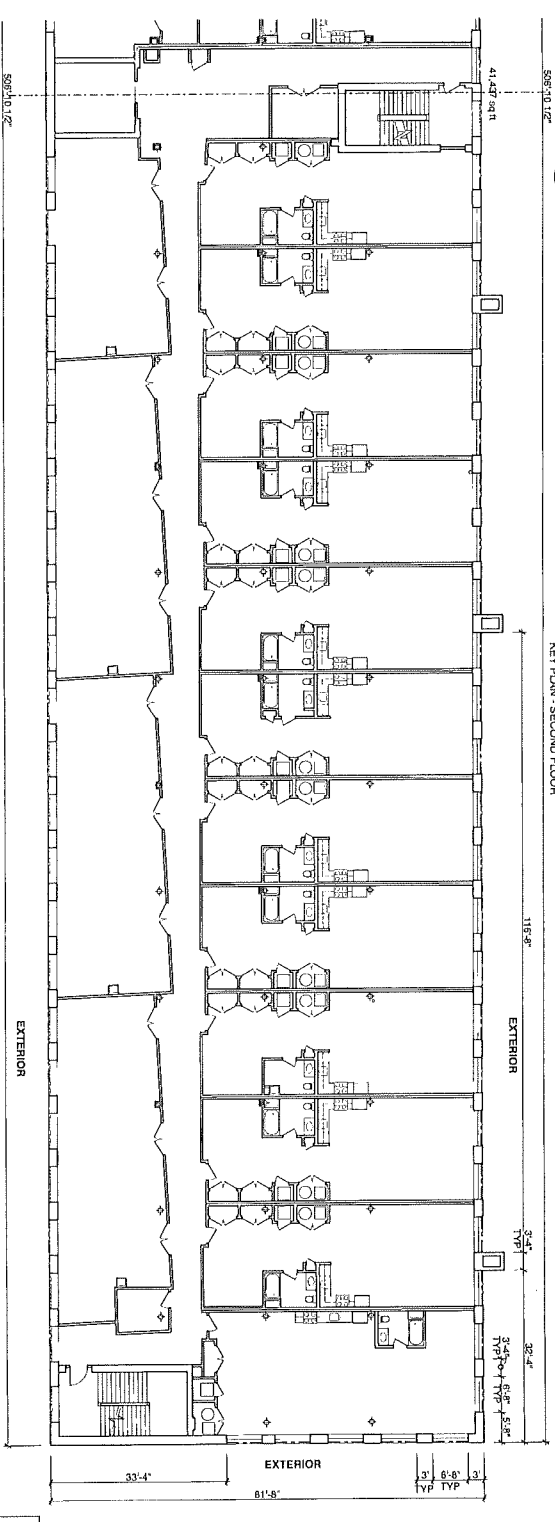

2 UNIT 6 PLAN-SECOND FLOOR-RIGHT

KEY PLAN - SECOND FLOOR

UNIT 6 FLOOR AREAS	
GROUND FLOOR	41,182 s.f.
SECOND FLOOR	41,137 s.f.
THIRD FLOOR	4,029 s.f.
TOTAL AREA	124,270 s.f.

220-5

MASTER DEED FILING  
FLOOR PLANS

UNIT 6  
MOTHER BROOK CONDOMINIUM  
WESTINGHOUSE PLAZA  
DAMON PLACE BOSTON, MA 02136

Prepared by  
Copyright Architectural Architects  
Cambridge, MA 02139  
(617) 578-0042 Fax (617) 578-5545

Date: 12/21/09  
Scale: 1/4" = 1'-0"  
0' 4' 0"

I hereby certify that these plans have been prepared in accordance with the provisions of the Registration of Professional Engineers of the Register of Professional Engineers of the State of Massachusetts.  
MA Reg. # 29322  
Date: 12/21/09


I hereby certify that these plans fully and accurately depict, as of July 16, 2009, the dimensions of the units, as built and that the building has no specific name.  
Registered Architect  
MA Reg. # 29322  
Date: 12/21/09



RESERVED FOR REGISTRY USE


UNIT 6 - SECOND FLOOR PLAN

220-5

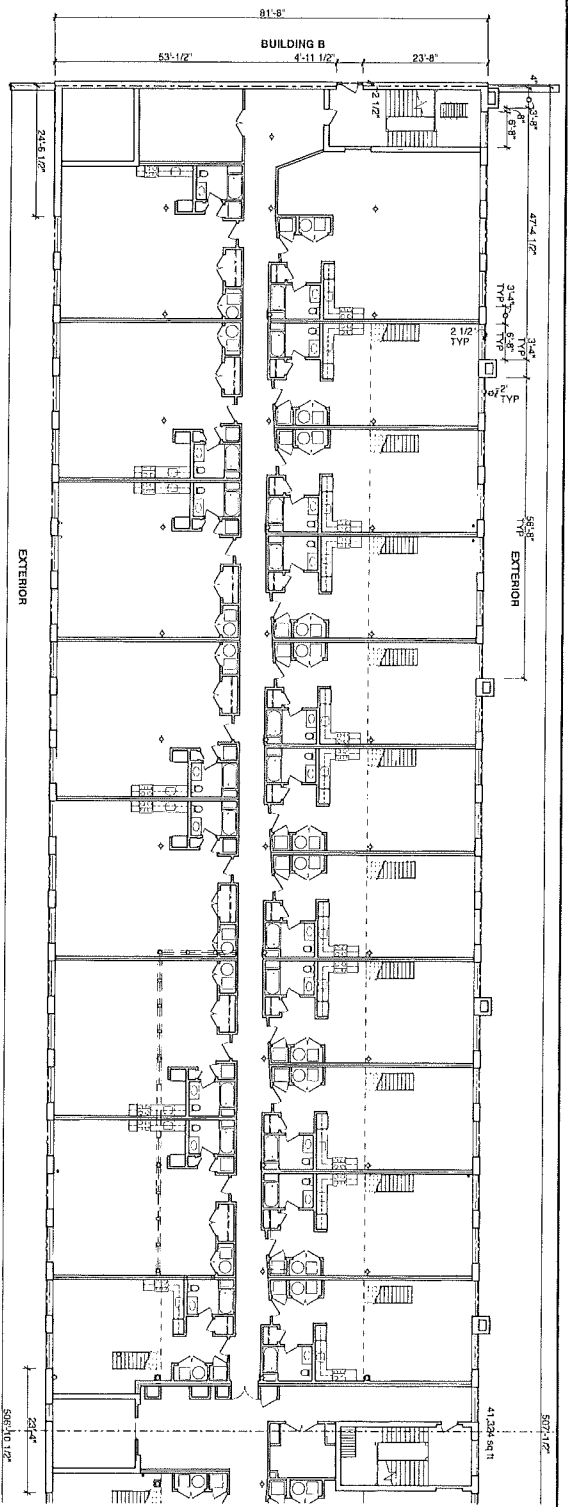

1 UNIT 6 PLAN-THIRD FLOOR-LEFT  
SCALE: 3/32" = 1'-0"

KEY PLAN - THIRD FLOOR

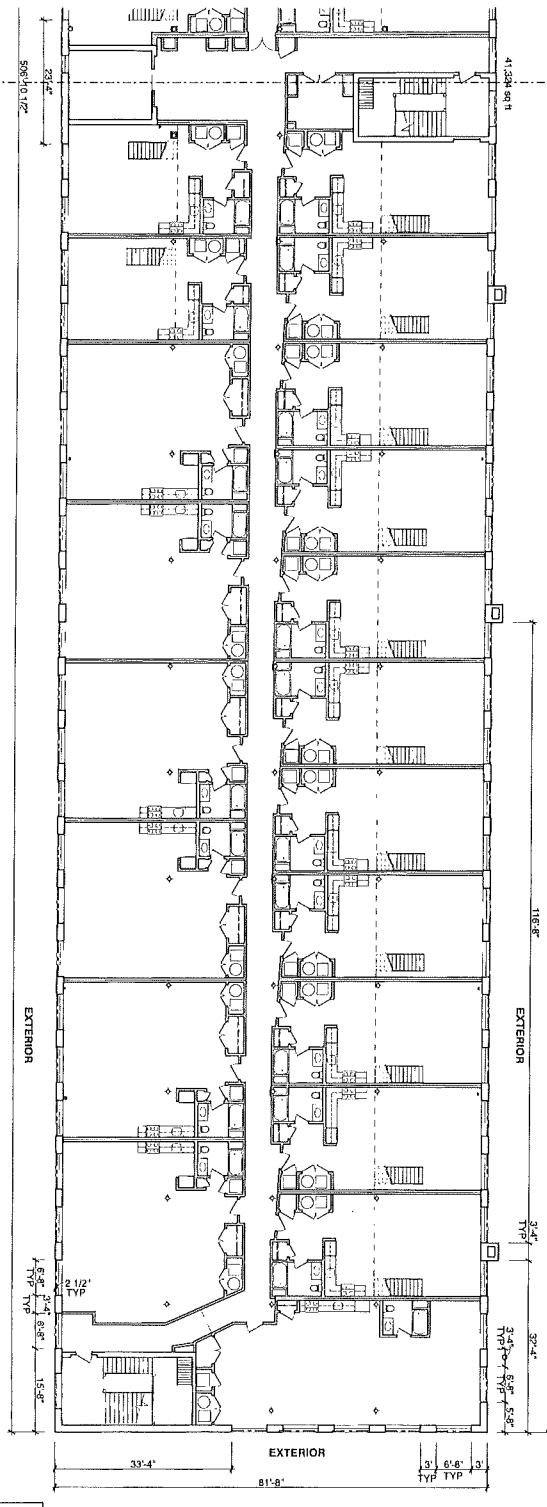

2 UNIT 6 PLAN-THIRD FLOOR-RIGHT  
SCALE: 3/32" = 1'-0"

KEY PLAN - THIRD FLOOR

**UNIT 6 FLOOR AREAS**

GROUND FLOOR	41,152 sq. ft.
THIRD FLOOR	41,324 sq. ft.
LOFT LEVEL	8,357 sq. ft.
TOTAL AREA	132,770 sq. ft.

2010-5

UNIT 6 - THIRD FLOOR PLAN

RESERVED FOR REGISTRY USE




I hereby certify that these plans have been prepared in accordance with the rules and regulations of the Registry of Deeds.  
 Prepared and Drawn by: Gregory Alan Davis, 12/27/09  
 Registered Architect  
 Matched and Checked by: [Signature], 12/28/09  
 Matched and Checked by: [Signature], 12/28/09  
 Matched and Checked by: [Signature], 12/28/09

Prepared by:  
 Gregory Alan Davis  
 21 Bulfinch Alley Drive  
 Boston, MA 02110  
 (617) 576-6242 Fax (617) 576-5549  
 Date: 12/27/09  
 Scale: 3/32" = 1'-0"  
 0" = 4'-0"

**MASTER DEED FILING FLOOR PLANS**


UNIT 6  
 MOTHER BROOK CONDOMINIUM  
 WESTINGHOUSE PLAZA  
 DAMON PLACE BOSTON, MA 02136

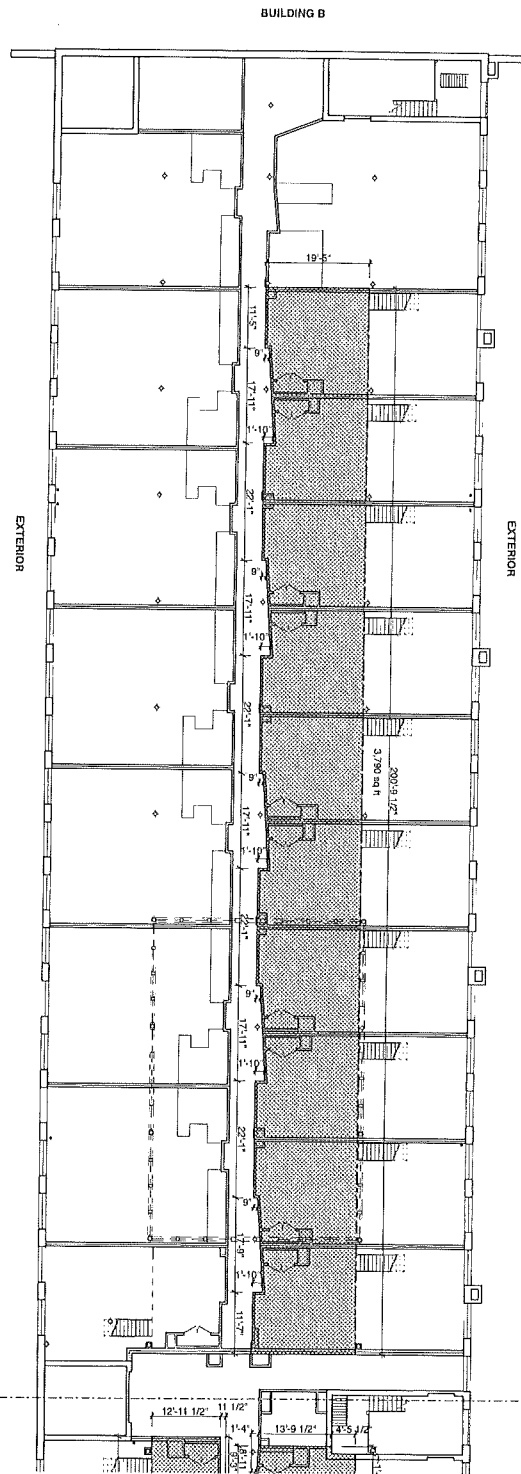

1 UNIT 6 PLAN-LOFT LEVEL  
SCALE: 3/32" = 1'-0"

KEY PLAN - LOFT LEVEL

MATCH LINE

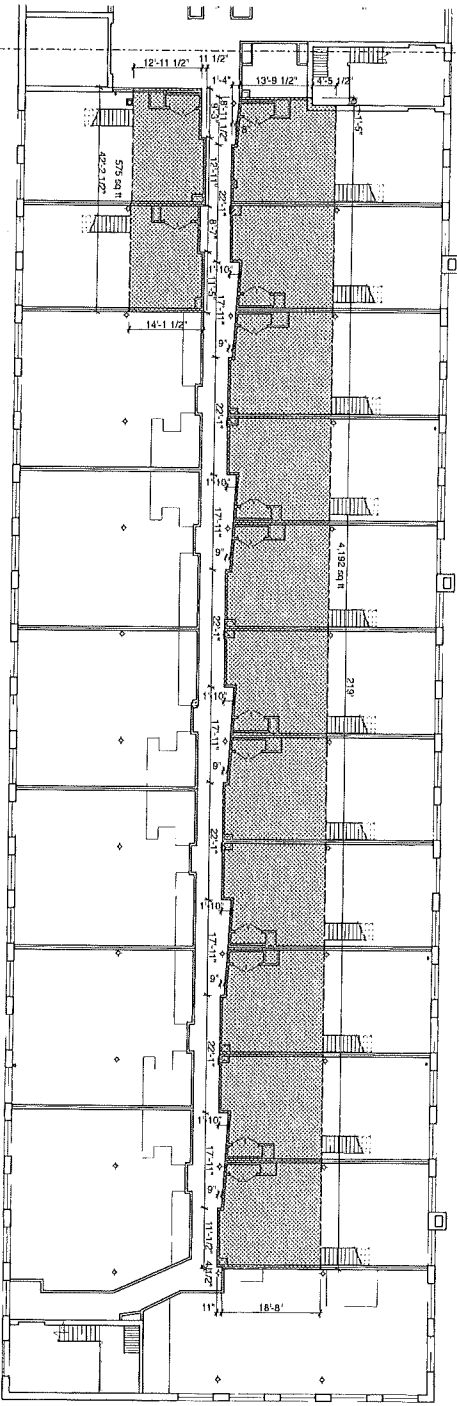

2 UNIT 6 PLAN-LOFT LEVEL  
SCALE: 3/32" = 1'-0"

KEY PLAN - LOFT LEVEL

MATCH LINE

**UNIT 6 FLOOR AREAS**

GROUND FLOOR	41,187 S.F.
SECOND FLOOR	41,324 S.F.
THIRD FLOOR	41,324 S.F.
TOTAL AREA	123,835 S.F.

2010-5

**MASTER DEED FILING  
FLOOR PLANS**

UNIT 6  
MOTHER BROOK CONDOMINIUM  
WESTINGHOUSE PLAZA  
DAMON PLACE BOSTON, MA 02136

Prepared by  
Conroyman Associate Architects  
21 Building North Drive  
Boston, MA 02119  
(617) 576-0424 Fax (617) 576-5543

Date: 12/27/09  
Scale: 3/32" = 1'-0"



I hereby certify that these floor plans have been prepared in accordance with the rules and regulations of the Registry of Deeds.

Registered Architect: [Signature] Date: 12/27/09  
Map No. 97-0248  
I hereby certify that these floor plans, with and without amendments, were prepared in accordance with the rules and regulations of the Registry of Deeds. The location, unit numbers and the area of the units are built and that the building has no special value.

Registered Architect: [Signature] Date: 12/27/09  
Map No. 97-0248

*Conroy*

RESERVED FOR REGISTRY USE

2010-5

UNIT 8 - LOFT LEVEL PLAN